This plan is to be read with letter U/No. 4307 dt. 25 JAN 2017

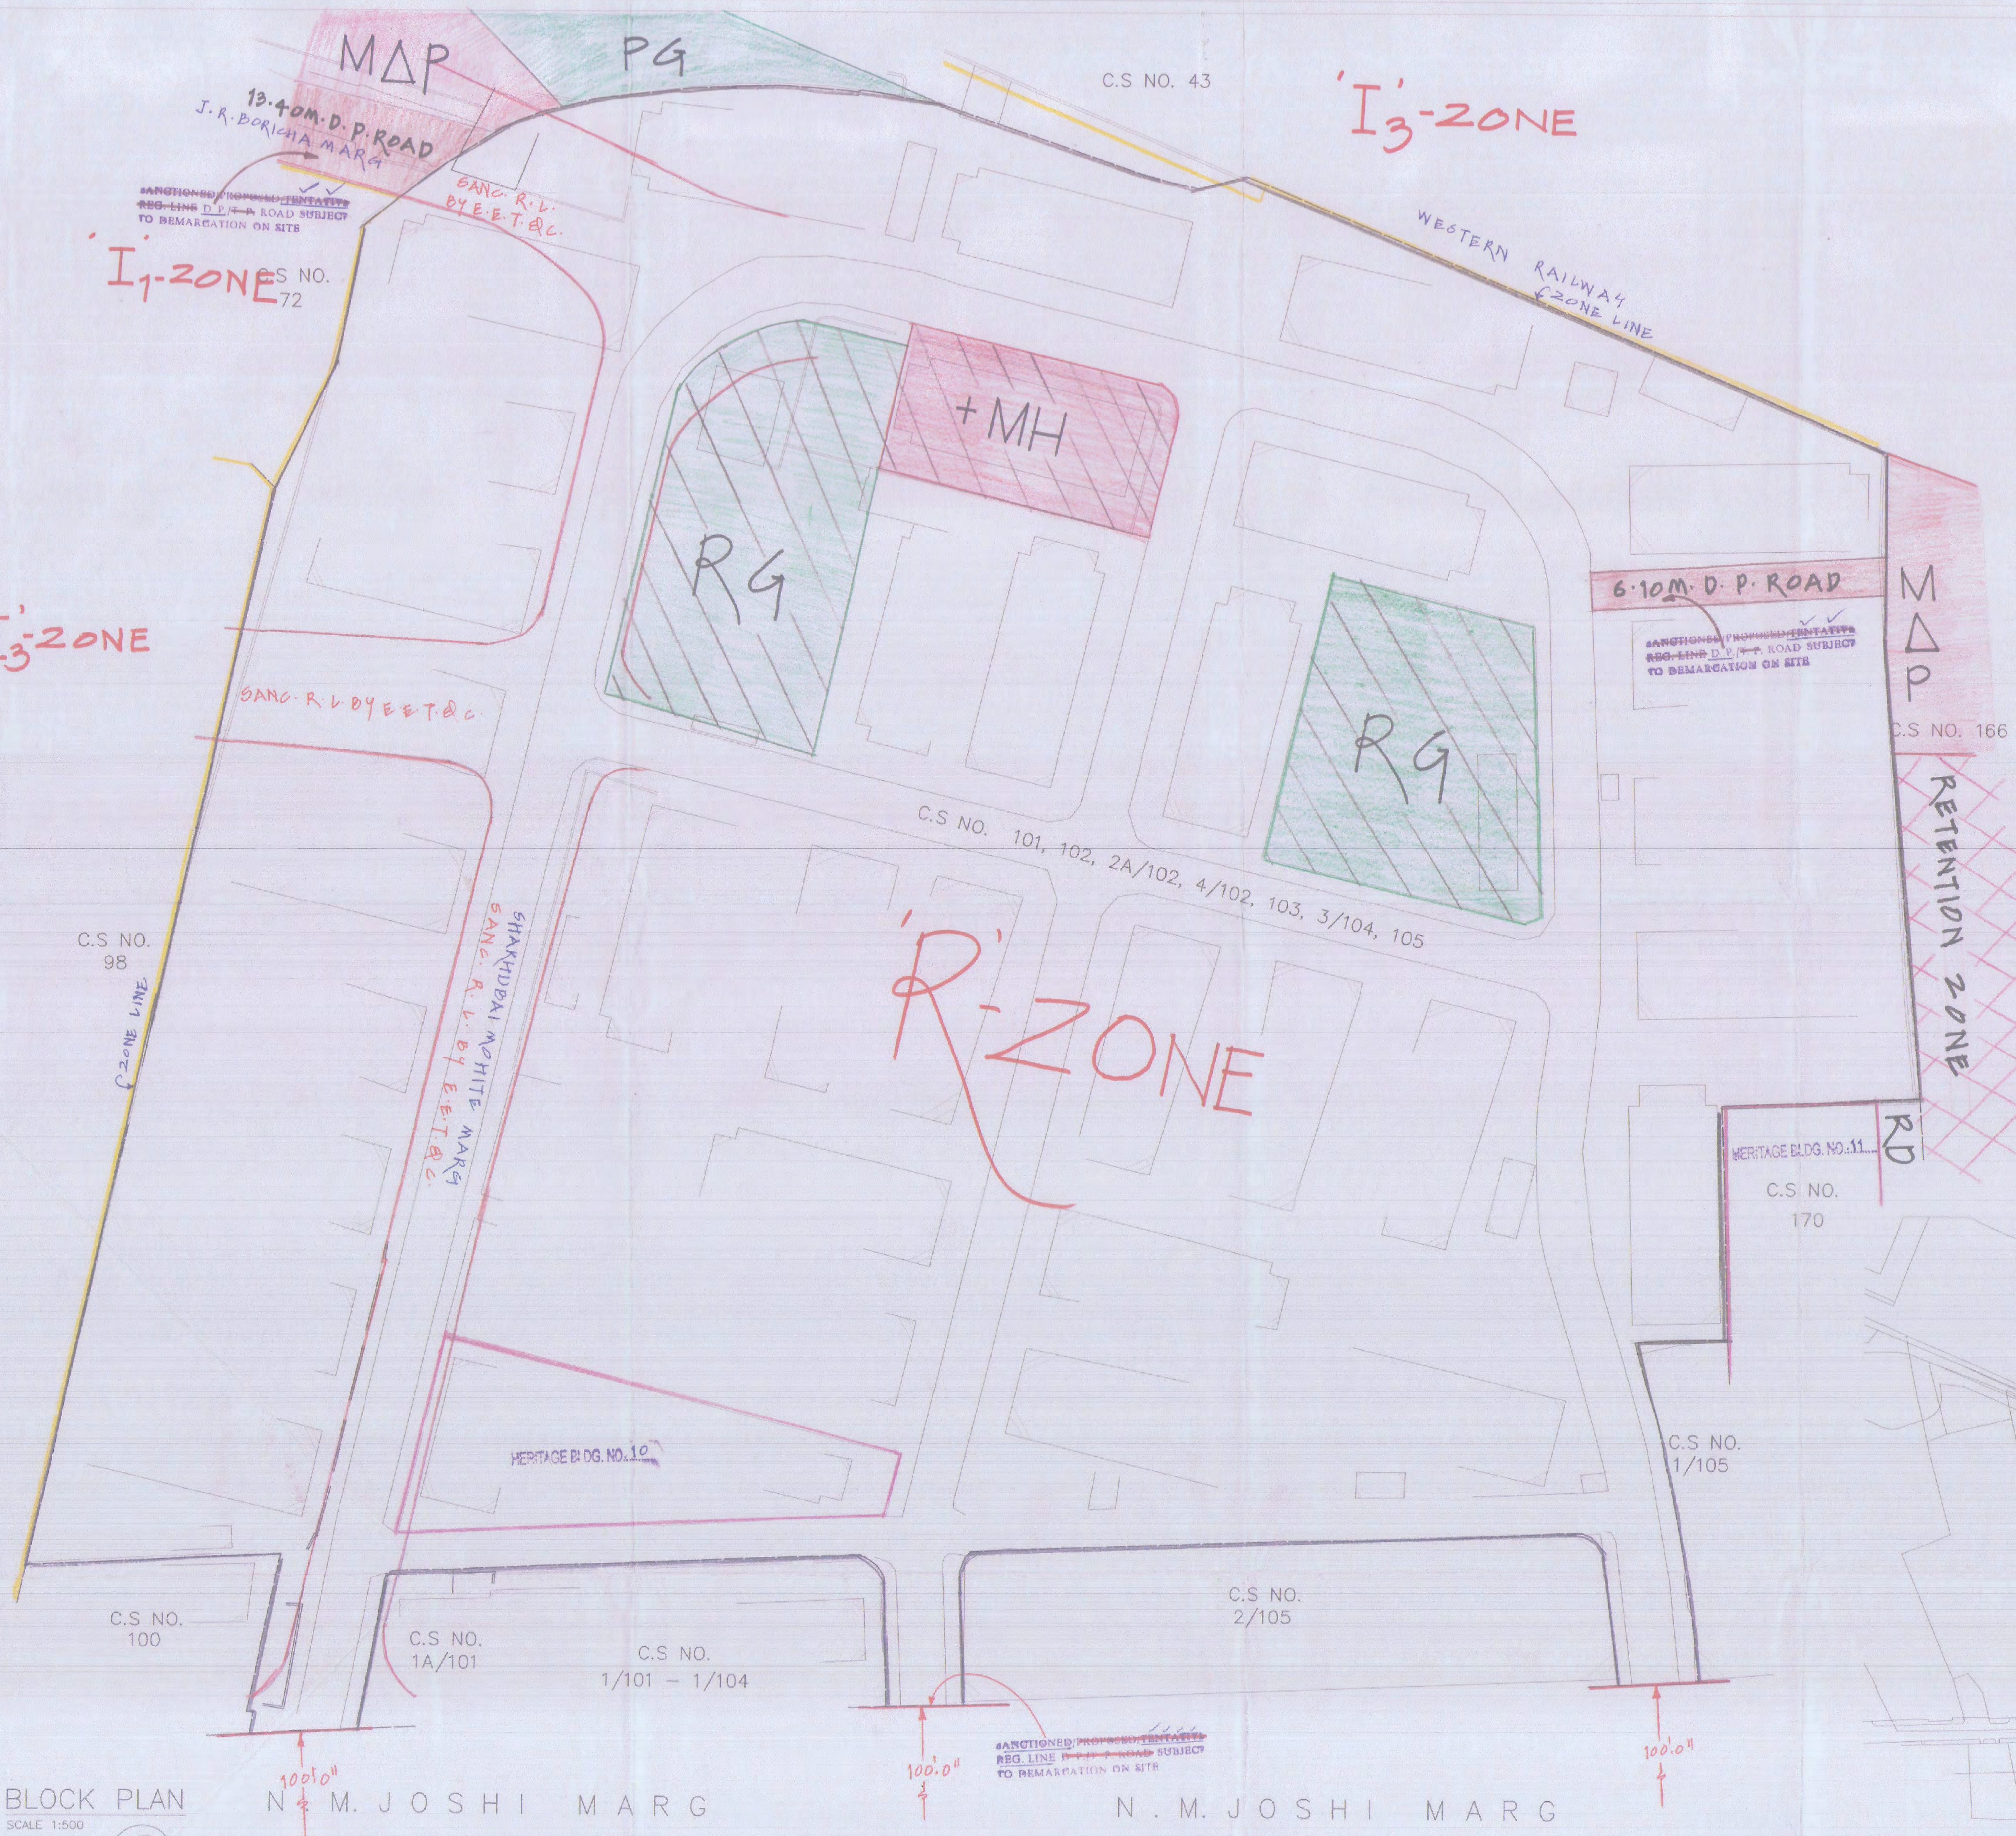
MΔP
PG
13.40M.D.P.ROAD
J.R.BORICHA MARG
~~SANCTIONED/PROPOSED/TENTATIVE~~
~~REG. LINE~~ D.P./~~T.P.~~ ROAD SUBJECT
TO DEMARCATION ON SITE
'I1'-ZONE
C.S NO. 72
SANC. R.L. BY E.E.T.&C.
C.S NO. 43
'I3'-ZONE
WESTERN RAILWAY
& ZONE LINE
+MH
RG
RG
6.10M. D. P. ROAD
~~SANCTIONED/PROPOSED/TENTATIVE~~
~~REG. LINE~~ D.P./~~T.P.~~ ROAD SUBJECT
TO DEMARCATION ON SITE
MΔP
C.S NO. 166
RETENTION ZONE
RD
'I3'-ZONE
SANC. R.L. BY E.E.T.&C.
SHAKHUBAI MOHITE MARG
SANC. R.L. BY E.E.T.&C.
C.S NO. 101, 102, 2A/102, 4/102, 103, 3/104, 105
'R'-ZONE
C.S NO. 98
& ZONE LINE
HERITAGE BLDG. NO.11
C.S NO. 170
HERITAGE BLDG. NO.10
C.S NO. 1/105
C.S NO. 100
C.S NO. 1A/101
C.S NO. 1/101 - 1/104
C.S NO. 2/105
100'.0"
100'.0"
100'.0"
SANCTIONED/~~PROPOSED/TENTATIVE~~
REG. LINE ~~D.P./T.P. ROAD~~ SUBJECT
TO DEMARCATION ON SITE
N.M. JOSHI MARG
N.M. JOSHI MARG

BLOCK PLAN

SCALE 1:500

NORTH

THERE IS SET-BACK
Block Plan is not correct

Remark's offered as per sanctioned
D. P. only.

Remarks are offered without verifying in the Existence of the Structures shown/not shown on block plan

ABUTTING TO THE HERITAGE BLDG. NO. 11, GRADE-IIB
HERITAGE BLDG. NO. 10, GRADE-III
MONO RAIL

DMAN (SUR)
(CITY)

05/01/17
Sub. Engineer (Survey),
(CITY)

05/01/2017
Asslt, Engineer (Survey)
(CITY)

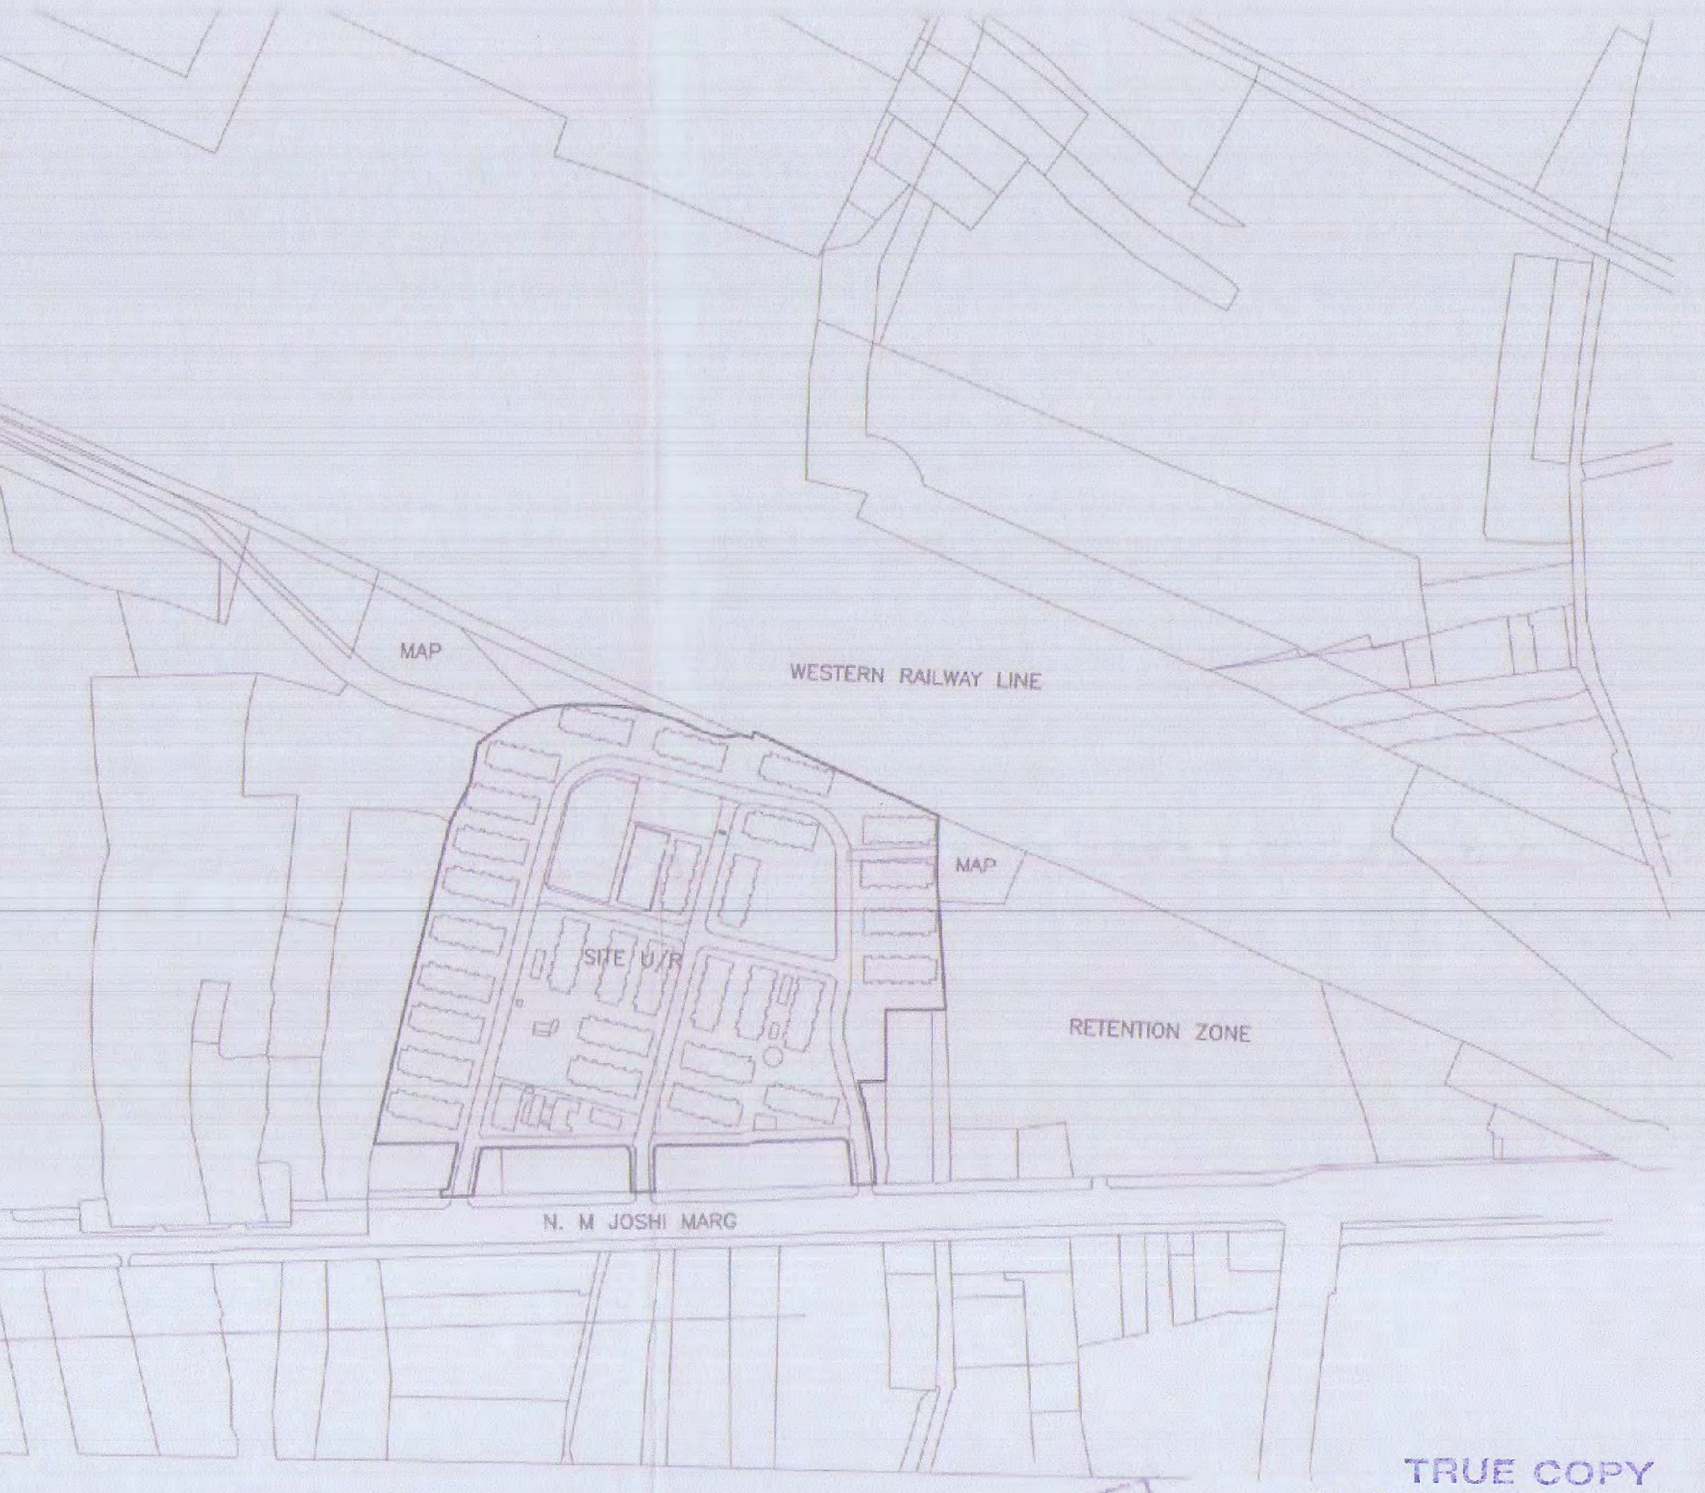
MAP
WESTERN RAILWAY LINE
MAP
SITE U/R
RETENTION ZONE
N. M JOSHI MARG

## LOCATION PLAN

SCALE 1:4000

TRUE COPY
For SUNIL AMBRE & ASSOCIATES

ARCHITECT

बृहन्मुंबई महानगरपालिका
कार्यकारी अभियंता
इमारत प्रस्ताव (शहर) १ यांचे कार्या.
दिनांक 26 DEC 2016
शहर १
इ इ बी पी /

## DESCRIPTION

PLAN SHOWING ON PLOT BEARING CTS NO. 101, 102, 2S/102, 4/102, 103, 3/104 & 105 OF LOWER PAREL DIVISION, SITUATED AT N. M. JOSHI MARG KNOWN AS BDD CHAWLS IN G/SOUTH WARD, MUMBAI.

Laxman Thite ★ Architect ★
Reg. No. CA/79/4894

LAXMAN
THITE ■
ARCHITECT
REG NO. = CA/79/4894

18, SHIVAJINAGAR, PUNE-5
TEL : 25536714/25536109
FAX : 25535930

IN ASSOCIATION WITH

TKS DESIGN SERVICES
18, SITAPARK,SHIVAJI
NAGAR, PUNE-5
PH.NO : 020-25531070,
020-25537377
EMAIL: tksarchitects@gmail.com

ingrain
5th Floor, ITTS House.
Kalaghoda, Fort, Mumbai 400001.
PH.NO : 022-66355760
EMAIL : ingrain@ingrainarchitects.com
WEB SITE: www.ingrain.co

SUNIL AMBRE & ASSOCIATES
ARCHITECTS
GND FLR, ABAN HOUSE, 25/31,SHREE SAIBABA MARG,
BEHIND RHYTHM HOUSE, KALA GHODA, FORT, MUMBAI.
PIN-400 023, TEL NO. 22024892, 22822067 / 2084