This plan is to be read with Letter U/No. 4907 dt. 25 JAN 2017

MAP

PG

13.40M. D. P. ROAD
J. R. BORICHA MARG

SANCTIONED/~~PROPOSED~~/~~TENTATIVE~~
~~REG. LINE~~ D. P. / ~~T. P.~~ ROAD SUBJECT TO DEMARCATION ON SITE

SANC. R. L. BY E. E. T. & C.

C.S NO. 43

'I3'-ZONE

WESTERN RAILWAY
CZONE LINE

'I1'-ZONE

C.S NO. 72

+MH

RG

RG

6.10M. D. P. ROAD

SANCTIONED/~~PROPOSED~~/~~TENTATIVE~~
~~REG. LINE~~ D. P. / ~~T. P.~~ ROAD SUBJECT TO DEMARCATION ON SITE

MAP

C.S NO. 166

RETENTION ZONE

'I3'-ZONE

SANC. R. L. BY E. E. T. & C.

C.S NO. 101, 102, 2A/102, 4/102, 103, 3/104, 105

'R'-ZONE

C.S NO. 98

CZONE LINE

SHAKHUPAI MACHHIE MARG
SANC. R. L. BY E. E. T. & C.

HERITAGE BLDG. NO. 11

RD

C.S NO. 170

HERITAGE BLDG. NO. 10

C.S NO. 1/105

C.S NO. 100

C.S NO. 1A/101

C.S NO. 1/101 – 1/104

C.S NO. 2/105

100'0"

100'0"

100'0"

SANCTIONED/~~PROPOSED~~/~~TENTATIVE~~
~~REG. LINE~~ ~~D. P. / T. P.~~ ROAD SUBJECT TO DEMARCATION ON SITE

N. M. JOSHI MARG

N. M. JOSHI MARG

THERE IS SET-BACK
Block Plan is not correct
Remark's offered as per sanctioned D. P. only.
Remarks are offered without verifying in the Existence of the Structures shown/not shown on block plan
ABUTTING TO THE HERITAGE BLDG. NO. 11, GRADE-IIB
HERITAGE BLDG. NO. 10, GRADE-III
MONO RAIL

DMAN (SUR) (CITY)

Sub. Engineer (Survey), (CITY)

Asstt. Engineer (Survey) (CITY)

BLOCK PLAN
SCALE 1:500

NORTH

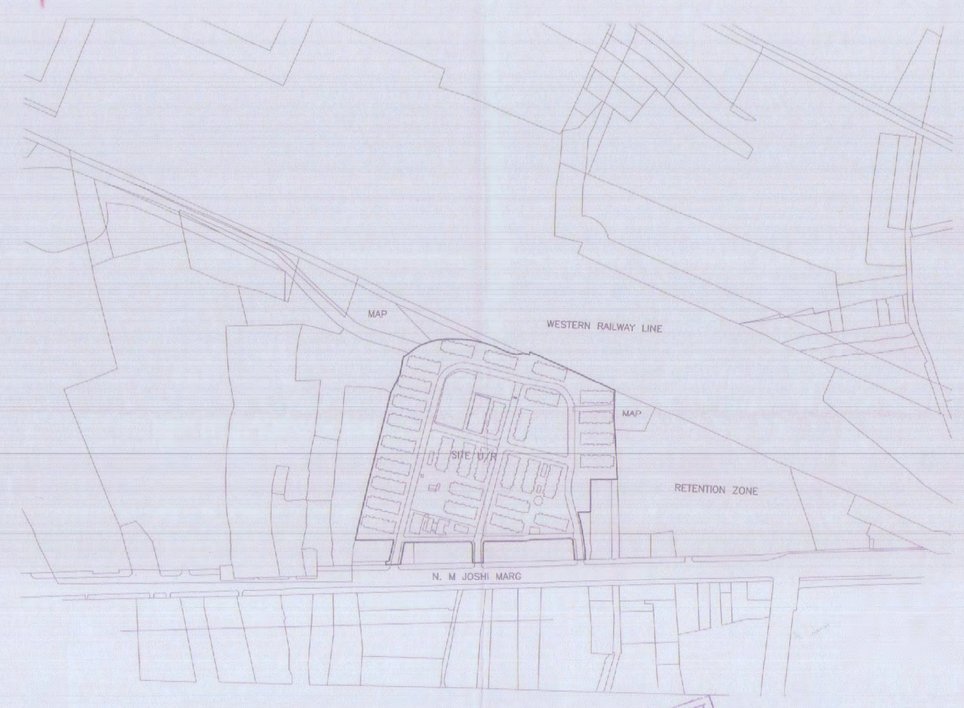

LOCATION PLAN
SCALE 1:4000

बृहन्मुंबई महानगरपालिका
अतिरिक्त आयुक्त (नगर) यांचे कार्यालय
प्राप्त झाल्याचा दिनांक 26 DEC 2016

DESCRIPTION

PLAN SHOWING ON PLOT BEARING CTS NO. 101, 102, 2S/102, 4/102, 103, 3/104 & 105 OF LOWER PAREL DIVISION, SITUATED AT N. M. JOSHI MARG KNOWN AS BDD CHAWLS IN G/SOUTH WARD, MUMBAI.

Laxman Thite Reg. No. CA/79/4894 Architect

LAXMAN THITE
ARCHITECT
REG NO. = CA/79/4894
18, SHIVAJINAGAR, PUNE-5
TEL. : 25536714/25536109
FAX : 25536930

IN ASSOCIATION WITH

TKS DESIGN SERVICES
18, SITAPARK,SHIVAJI NAGAR, PUNE-5
PH.NO : 020-25531070, 020-25537377
EMAIL: tksarchitects@gmail.com

ingrain
5th Floor, ITTS House, Kalaghoda, Fort, Mumbai 400001.
PH.NO : 022-66355760
EMAIL : ingrain@ingrainarchitects.com
WEB SITE: www.ingrain.co

SUNIL AMBRE & ASSOCIATES
ARCHITECTS
GND FLR, ABAN HOUSE, 25/31,SHREE SAIBABA MARG, BEHIND RHYTHM HOUSE, KALA GHODA, FORT, MUMBAI. PIN-400 023, TEL NO. 22024892, 22822067 / 2084